

REGISTERED SURVEYOR'S CERTIFICATION

I, Christopher Kliese, hereby certify that the vertical and horizontal locations and dimensions shown on this plan are true and correct record and were located by survey.

**NORRIS CLARKE & O'BRIEN PTY LTD**  
 ACN 056 870 770  
 Registered Surveyor (S3173) 4491 Date: 04/02/22

ENGINEER'S CERTIFICATION


I, Kelvin Howard, hereby certify that:

- The information contained in this drawing / document is in compliance with approved drawings and design.
- The new water and sewerage works defined by this drawing have been designed and constructed in accordance with the SEO Code.
- This represents an accurate record of as-constructed works.
- I accept responsibility for the information contained in this drawing / document.

RPEQ (Signature) RPEQ No. 7619 Date: 09/02/22

AS CONSTRUCTED

Datum for Levels ..... AHD  
 Levelled from GPS RTK AHD

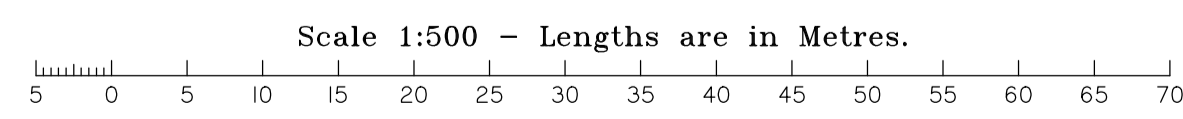

A1

INDEX	DATE	REVISIONS	DRAWN	CHECKED	PASSED
0	04/02/2022	ORIGINAL ISSUE	BRD	GWH	TJJ

DRAWN	CHECKED	PASSED	INITIALS	DATE
BRD	GWH	TJJ		04/02/2022
				04/02/2022
				04/02/2022

**Norris Clarke & O'Brien Pty Ltd**  
 Licensed Surveyors  
 Town Planners  
 Development Consultants

Level 1 - Aldi Centre  
 12 Bishop Street  
 Kelvin Grove QLD 4059  
 ph: 07 3012 0000  
 fax: 07 3012 0099  
 email: info@ncob.com.au  
 ACN: 056 870 770  
 ABN 15 056 870 770



**Queensland Urban Utilities**

CADENCE ESTATE - STAGE 2A - 20-PNT-47520  
 WATER AS CONSTRUCTED  
 AV JENNINGS

SCALE	1500
SHEET 1	OF 1 SHEETS
DRAWING NO.	10935AC-2A-WA