



ALL SEWER MAINS ARE DN160 PE100 SDR21 UNLESS NOTED OTHERWISE.

REGISTERED SURVEYOR'S CERTIFICATION

I, Christopher Klueber, hereby certify that the vertical and horizontal locations and dimensions shown on this plan are true and correct record and were located by survey.

*AKW*  
NORRIS CLARKE & O'BRIEN PTY LTD  
ACN 056 870 770  
Registered Surveyor (S) Reg. No. 4491 Date: 04/02/22

ENGINEER'S CERTIFICATION


I, Kelvin Howard, hereby certify that:

- The information contained in this drawing / document is in compliance with approved drawings and design.
- The new water and sewerage works defined by this drawing have been designed and constructed in accordance with the SEQ Code.
- This represents an accurate record of as-constructed works.
- I accept responsibility for the information contained in this drawing / document.

*Kevin Howard*  
RPEQ (Signature) RPEQ No. 7619 Date: 09/02/22

AS CONSTRUCTED

Datum for Levels ..... AHD  
Levelled from GPS RTK AHD

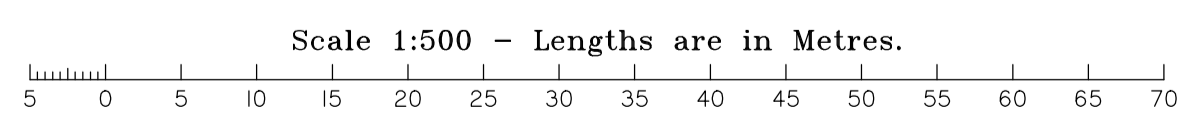

A1	0	04/02/2022	ORIGINAL ISSUE	BRD	GWJ	TJJ
	INDEX	DATE	REVISIONS	DRAWN	CHECKED	PASSED

DRAWN	BRD	04/02/2022
CHECKED	GWJ	04/02/2022
PASSED	TJJ	04/02/2022
INITIALS	DATE	

Norris Clarke & O'Brien Pty Ltd  
Licensed Surveyors  
Town Planners  
Development Consultants

Level 1 - Aldi Centre  
12 Bishop Street  
Kelvin Grove QLD 4059  
ph: 07 3012 0000  
fax: 07 3012 0099  
email: info@ncob.com.au  
ACN: 056 870 770  
ABN 15 056 870 770



Queensland Urban Utilities

CADENCE ESTATE - STAGE 2B - 20-PNT-48059  
SEWER AS CONSTRUCTED  
AV JENNINGS

SCALE	1:500
SHEET 1	OF 1 SHEETS
DRAWING NO.	10935AC-2B-SEW