

**AS CONSTRUCTED CERTIFICATION**

I, Kelvin Howard  
(Company's representative Name) (Signature)

7619  
(Date) (RPEQ)

Being a duly representative of -  
SCG Urban (Company Name)

528  
S3157  
(Below Depth)

Hereby certify that

- The information contained in this drawing / document is in compliance with approved drawings and design supplied under the terms of the contract.
- This represents an accurate "As constructed" record of works carried out and accept responsibility for the information contained in this drawing / document.

**REGISTERED SURVEYOR'S CERTIFICATION**

I, Christopher Klutke hereby certify that the vertical and horizontal locations and dimensions shown on this plan are a true and correct record and were located by survey.


**NORRIS CLARKE & O'BRIEN PTY LTD**  
056 870 770

AKW

Registered Surveyor No. 4491 Date: 14/10/22

**COORDINATE DATUM NOTE:**  
HORIZONTAL COORDINATES (E.N) SUPPLIED ARE MAPPING GRID OF AUSTRALIA (MGA), ZONE 56 BASED ON THE UNIVERSAL TRANSVERSE MERCATOR PROJECTION AND THE GEOCENTRIC DATUM OF AUSTRALIA 1994.

**AS CONSTRUCTED**

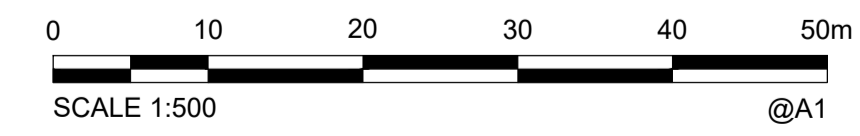

<b>A1</b>						
	A	14/10/2022	ORIGINAL ISSUE	VS	TJ	TJ
	INDEX	DATE	REVISIONS	DRAWN	CHECKED	PASSED

DRAWN	VS	14/10/2022
CHECKED	TJ	14/10/2022
PASSED	TJ	14/10/2022
INITIALS	DATE	

**Norris Clarke & O'Brien Pty Ltd**  
Licensed Surveyors  
Town Planners  
Development Consultants

Level 1 - Aldi Centre  
12 Bishop Street  
Kelvin Grove QLD 4059  
ph: 07 3012 0000  
fax: 07 3012 0099  
email: info@ncob.com.au  
ACN 056 870 770  
ABN 15 056 870 770



**IPSWICH CITY COUNCIL**

CADENCE ESTATE - STAGE 3A  
STORMWATER AS CONSTRUCTED  
AV JENNINGS

SCALE	500
SHEET	1 OF 1 SHEETS
DRAWING NO.	10935AC3A-SW