

ALL SEWER MAINS ARE DN160 PE100 SDR21 UNLESS NOTED OTHERWISE.

REGISTERED SURVEYOR'S CERTIFICATION

I, Christopher Klibe, hereby certify that the vertical and horizontal locations and dimensions shown on this plan are true and correct record and were located by survey.

**NORRIS CLARKE & O'BRIEN PTY LTD**  
 CAK  
 Registered Surveyor No. 4491 Date: 04/02/22

ENGINEER'S CERTIFICATION


Kelvin Howard, hereby certify that:

- The information contained in this drawing / document is in compliance with approved drawings and design.
- The new water and sewerage works defined by this drawing have been designed and constructed in accordance with the SED Code.
- This represents an accurate record of as-constructed works.
- I accept responsibility for the information contained in this drawing / document.

RPEQ (Signature) RPEQ No. 7619 Date: 09/02/22

AS CONSTRUCTED

Datum for Levels ..... AHD  
Levelled from GPS RTK AHD

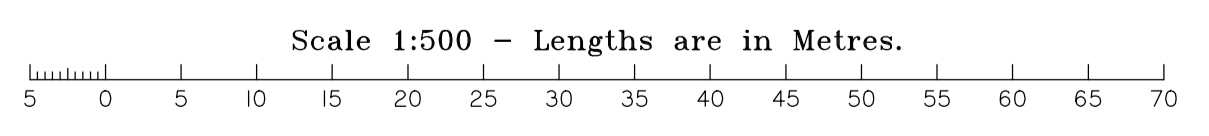

A1	0	04/02/2022	ORIGINAL ISSUE	BRO	GWH	TJJ
	INDEX	DATE	REVISIONS	DRAWN	CHECKED	PASSED

Norris Clarke & O'Brien Pty Ltd  
 Licensed Surveyors  
 Town Planners  
 Development Consultants

Level 1 - Aldi Centre  
 12 Bishop Street  
 Kelvin Grove QLD 4059  
 ph: 07 3012 0000  
 fax: 07 3012 0099  
 email: info@ncob.com.au  
 ACN 056 870 770  
 ABN 15 056 870 770

QUEENSLAND  
 UrbanUtilities

Queensland Urban Utilities

CADENCE ESTATE - STAGE 2A - 20-PNT-47520  
 SEWER AS CONSTRUCTED  
 AV JENNINGS

SCALE	1:500
SHEET 1	OF 1 SHEETS
DRAWING NO.	10935AC-2A-SEW