

ALL SEWER MAINS ARE DN160 PE100 SDR21 UNLESS NOTED OTHERWISE.

REGISTERED SURVEYOR'S CERTIFICATION

I, Christopher Norris Clarke & O'Brien Pty Ltd, hereby certify that the vertical and horizontal locations and dimensions shown on this plan are a true and correct record and were located by survey.

NORRIS CLARKE & O'BRIEN PTY LTD
 CALUM NORRIS
 Registered Surveyor (Snr) Reg. Surveyor No. 4491 Date: 14/10/22

ENGINEER'S CERTIFICATION

I, Kelvin Howard, hereby certify that:

- The information contained in this drawing / document is in compliance with approved drawings and design.
- The new water and sewerage works defined by this drawing have been designed and constructed in accordance with the SED Code.
- This represents an accurate record of as-constructed works.
- I accept responsibility for the information contained in this drawing / document.

RPED (Signature) RPED No. 7619 Date:

AS CONSTRUCTED

Datum for Levels AHD
 Levelled from GPS RTK AHD

Scale 1:500 - Lengths are in Metres.

0 5 10 15 20 25 30 35 40 45 50 55 60 65 70

A1	0	14/10/2022	ORIGINAL ISSUE	VS	GW	TJJ
	INDEX	DATE	REVISIONS	DRAWN	CHECKED	PASSED

Norris Clarke & O'Brien Pty Ltd
 Licensed Surveyors
 Town Planners
 Development Consultants

Level 1 - Aldi Centre
 12 Bishop Street
 Kelvin Grove QLD 4059
 ph: 07 3012 0000
 fax: 07 3012 0099
 email: info@ncob.com.au
 ACN: 056 870 770
 ABN 15 056 870 770



Queensland Urban Utilities

CADENCE ESTATE - STAGE 3A - 21-PNT-52574
 SEWER AS CONSTRUCTED
 AV JENNINGS

SCALE	1500
SHEET 1	OF 1 SHEETS
DRAWING NO.	10935AC-3A-SEW



REGISTERED SURVEYOR'S CERTIFICATION

I, Christopher *Clarke*, hereby certify that the vertical and horizontal locations and dimensions shown on this plan are a true and correct record and were located by survey.

NORRIS CLARKE & O'BRIEN PTY LTD
 CALUM NORRIS
 Registered Surveyor (No. 4491) Date: 10/10/22

ENGINEER'S CERTIFICATION


I, Kelvin Howard, hereby certify that:

- The information contained in this drawing / document is in compliance with approved drawings and design.
- The new water and sewerage works defined by this drawing have been designed and constructed in accordance with the SEQ Code.
- This represents an accurate record of as-constructed works.
- I accept responsibility for the information contained in this drawing / document.

RPED (signature) _____ RPED No. 7619 Date: _____

AS CONSTRUCTED

Datum for Levels AHD
 Levelled from GPS RTK AHD

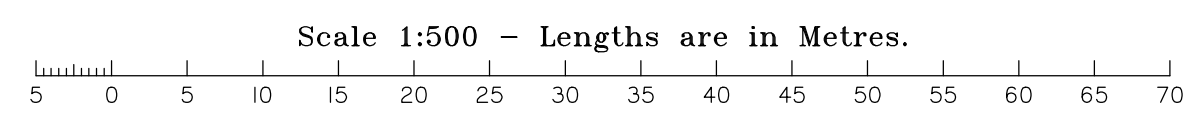

A1

INDEX	DATE	REVISIONS	DRAWN	CHECKED	PASSED
0	14/10/2022	ORIGINAL ISSUE	VS	GW	TJJ

INITIALS	DATE
VS	14/10/2022
GW	14/10/2022
TJJ	14/10/2022

Norris Clarke & O'Brien Pty Ltd
 Licensed Surveyors
 Town Planners
 Development Consultants

Level 1 - Aldi Centre
 12 Bishop Street
 Kelvin Grove QLD 4059
 ph: 07 3012 0000
 fax: 07 3012 0099
 email: info@ncob.com.au
 ACN: 056 870 770
 ABN 15 056 870 770



Queensland Urban Utilities

CADENCE ESTATE - STAGE 3A - 21-PNT-52574
 WATER AS CONSTRUCTED
 AV JENNINGS

SCALE	1500
SHEET 1	OF 1 SHEETS
DRAWING NO.	10935AC-3A-WAT