


FOR CONTINUATION REFER LEFT



FOR CONTINUATION REFER RIGHT

Scale 1:500 - Lengths are in Metres.

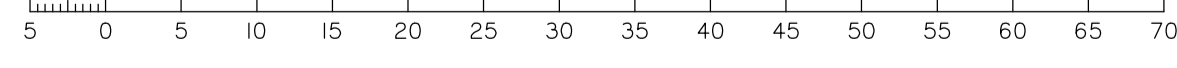

Datum for Levels AHD
Levelled from GPS RTK AHD

ALL SEWER MAINS ARE DN160 PE100 SDR21 UNLESS NOTED OTHERWISE.

REGISTERED SURVEYOR'S CERTIFICATION
I, Christopher Klibbe, hereby certify that the vertical and horizontal locations and dimensions shown on this plan are a True and correct record and were located by survey.
Registered Surveyor (Sig.) Reg. Surveyor No. 4491 Date: _____

ENGINEER'S CERTIFICATION
I, Kelvin Howard, hereby certify that:
1. The information contained in this drawing / document is in compliance with approved drawings and design.
2. The new water and sewerage works defined by this drawing have been designed and constructed in accordance with the SEQ Code.
3. This represents an accurate record of as-constructed works
4. I accept responsibility for the information contained in this drawing / document.
RPQE (Signature) _____ RPQE No. 7619 Date: _____

AS CONSTRUCTED

A1	0	14/10/2022	ORIGINAL ISSUE	VS	GW	TJJ
	INDEX	DATE	REVISIONS	DRAWN	CHECKED	PASSED

DRAWN	VS	14/10/2022
CHECKED	GW	14/10/2022
PASSED	TJJ	14/10/2022
INITIALS		DATE

Norris Clarke & O'Brien Pty Ltd
Licensed Surveyors
Town Planners
Development Consultants


Level 1 - Aldi Centre
12 Bishop Street
Kelvin Grove QLD 4059
ph: 07 3012 0000
fax: 07 3012 0099
email: info@ncob.com.au
ACN: 056 870 770
ABN 15 056 870 770



Queensland Urban Utilities

CADENCE ESTATE - STAGE 3B & 3C - 21-PNT-52575
SEWER AS CONSTRUCTED
AV JENNINGS

SCALE	1:500
SHEET 1 OF 1 SHEETS	
DRAWING NO.	10935AC-3BC-SEW

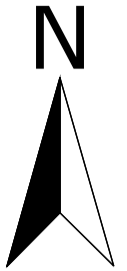

REGISTERED SURVEYOR'S CERTIFICATION

I, Christopher Klippe, hereby certify that the vertical and horizontal locations and dimensions shown on this plan are a true and correct record and were located by survey.

Registered Surveyor (sig) Reg. Surveyor No. 4491 Date: _____

ENGINEER'S CERTIFICATION


I, Kelvin Howard, hereby certify that:

- The information contained in this drawing / document is in compliance with approved drawings and design.
- The new water and sewerage works defined by this drawing have been designed and constructed in accordance with the SEQ Code.
- This represents an accurate record of as-constructed works.
- I accept responsibility for the information contained in this drawing / document.

RPEQ (signature) RPEQ No. 7619 Date: _____

AS CONSTRUCTED

Datum for Levels AHD
Levelled from GPS RTK AHD

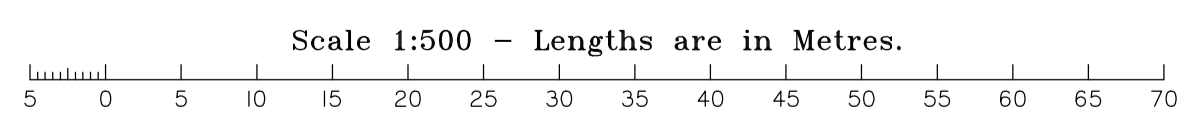

A1

INDEX	DATE	REVISIONS	DRAWN	CHECKED	PASSED
0	14/10/2022	ORIGINAL ISSUE	VS	GWH	TJJ

DRAWN	CHECKED	PASSED	INITIALS	DATE
VS	GWH	TJJ		14/10/2022
GWH				14/10/2022
TJJ				14/10/2022

Norris Clarke & O'Brien Pty Ltd
Licensed Surveyors
Town Planners
Development Consultants

NCB

Level 1 - Aldi Centre
12 Bishop Street
Kelvin Grove QLD 4059
ph: 07 3012 0000
fax: 07 3012 0099
email: info@ncob.com.au
ACN: 056 870 770
ABN 15 056 870 770



Queensland Urban Utilities

CADENCE ESTATE - STAGE 3B & 3C - 21-PNT-52575
WATER AS CONSTRUCTED
AV JENNINGS

SCALE	1500
SHEET 1	OF 1 SHEETS
DRAWING NO.	10935AC-3BC-WA